


**KEY PLAN**

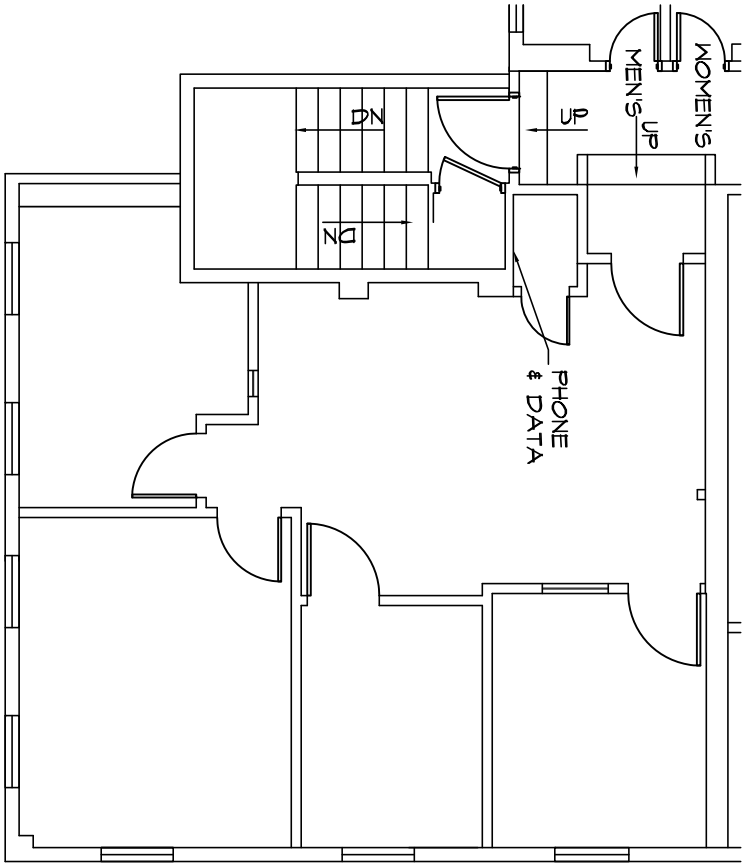

CARDARELLI  
DESIGN & ARCHITECTURE, P.C.  
Architecture and Planning  
297 KADVOGAN ROAD, SUITE 202  
GREENWICH, CT 06830  
Phone: (914) 437-5554 / Fax: (914) 437-5555

**2FL**

DATE:  
2/24/16

SCALE:  
1/8" = 1'-0"

**AS-BUILT PLAN**  
**79 EAST PUTNAM AVENUE**  
**GREENWICH, CT 06830**

GHP OFFICE REALTY  
FOUR WEST RED OAK LANE  
WHITE PLAINS, NY 10604  
Tel: 914.694.6070  
Fax: 914.694.6072

